

BENCHMARK

ELEVATIONS ARE BASED ON RTK GPS OBSERVATIONS TAKEN ON APRIL 25, 2018 USING THE OREGON REAL-TIME GEODETIC NETWORK AND GEOID 12A(NAVD88)


NOTES

- LOCATIONS OF UNDERGROUND UTILITIES SHOWN ARE BASED ON A COMBINATION OF VISIBLE FACILITIES LOCATED ABOVE GROUND, AS BUILT DRAWINGS AND UTILITY LOCATE MARKS. NO CERTIFICATION IS MADE TO ACTUAL LOCATION OF UNDERGROUND UTILITIES.
- CONTOUR INTERVAL = 1.0 FOOT

PROPERTY LINE

- — — — — PROPERTY LINE
- · — · — · — TOP OF SWALE
- · · — · · — BOTTOM OF SWALE
- / / / / — EDGE OF ASPHALT
- x — x — x — FENCE LINE
- - - - - E - - - - - UNDERGROUND ELECTRICAL LINE
- 2" DECIDUOUS SAPLING TREE, TYP.
- ⊠ TELEPHONE RISER
- ⊞ WATER METER
- ⊞ VALVE
- ⊞ SEPTIC TANK LID
- ▨ CONCRETE

CURVE TABLE				
CURVE	DELTA	RADIUS	ARC	CHORD
C1	27.307483°	19.84	9.46	N13°49'41"W 9.37
C2	337.598333°	20.00	7.82	S79°08'17"E 7.77

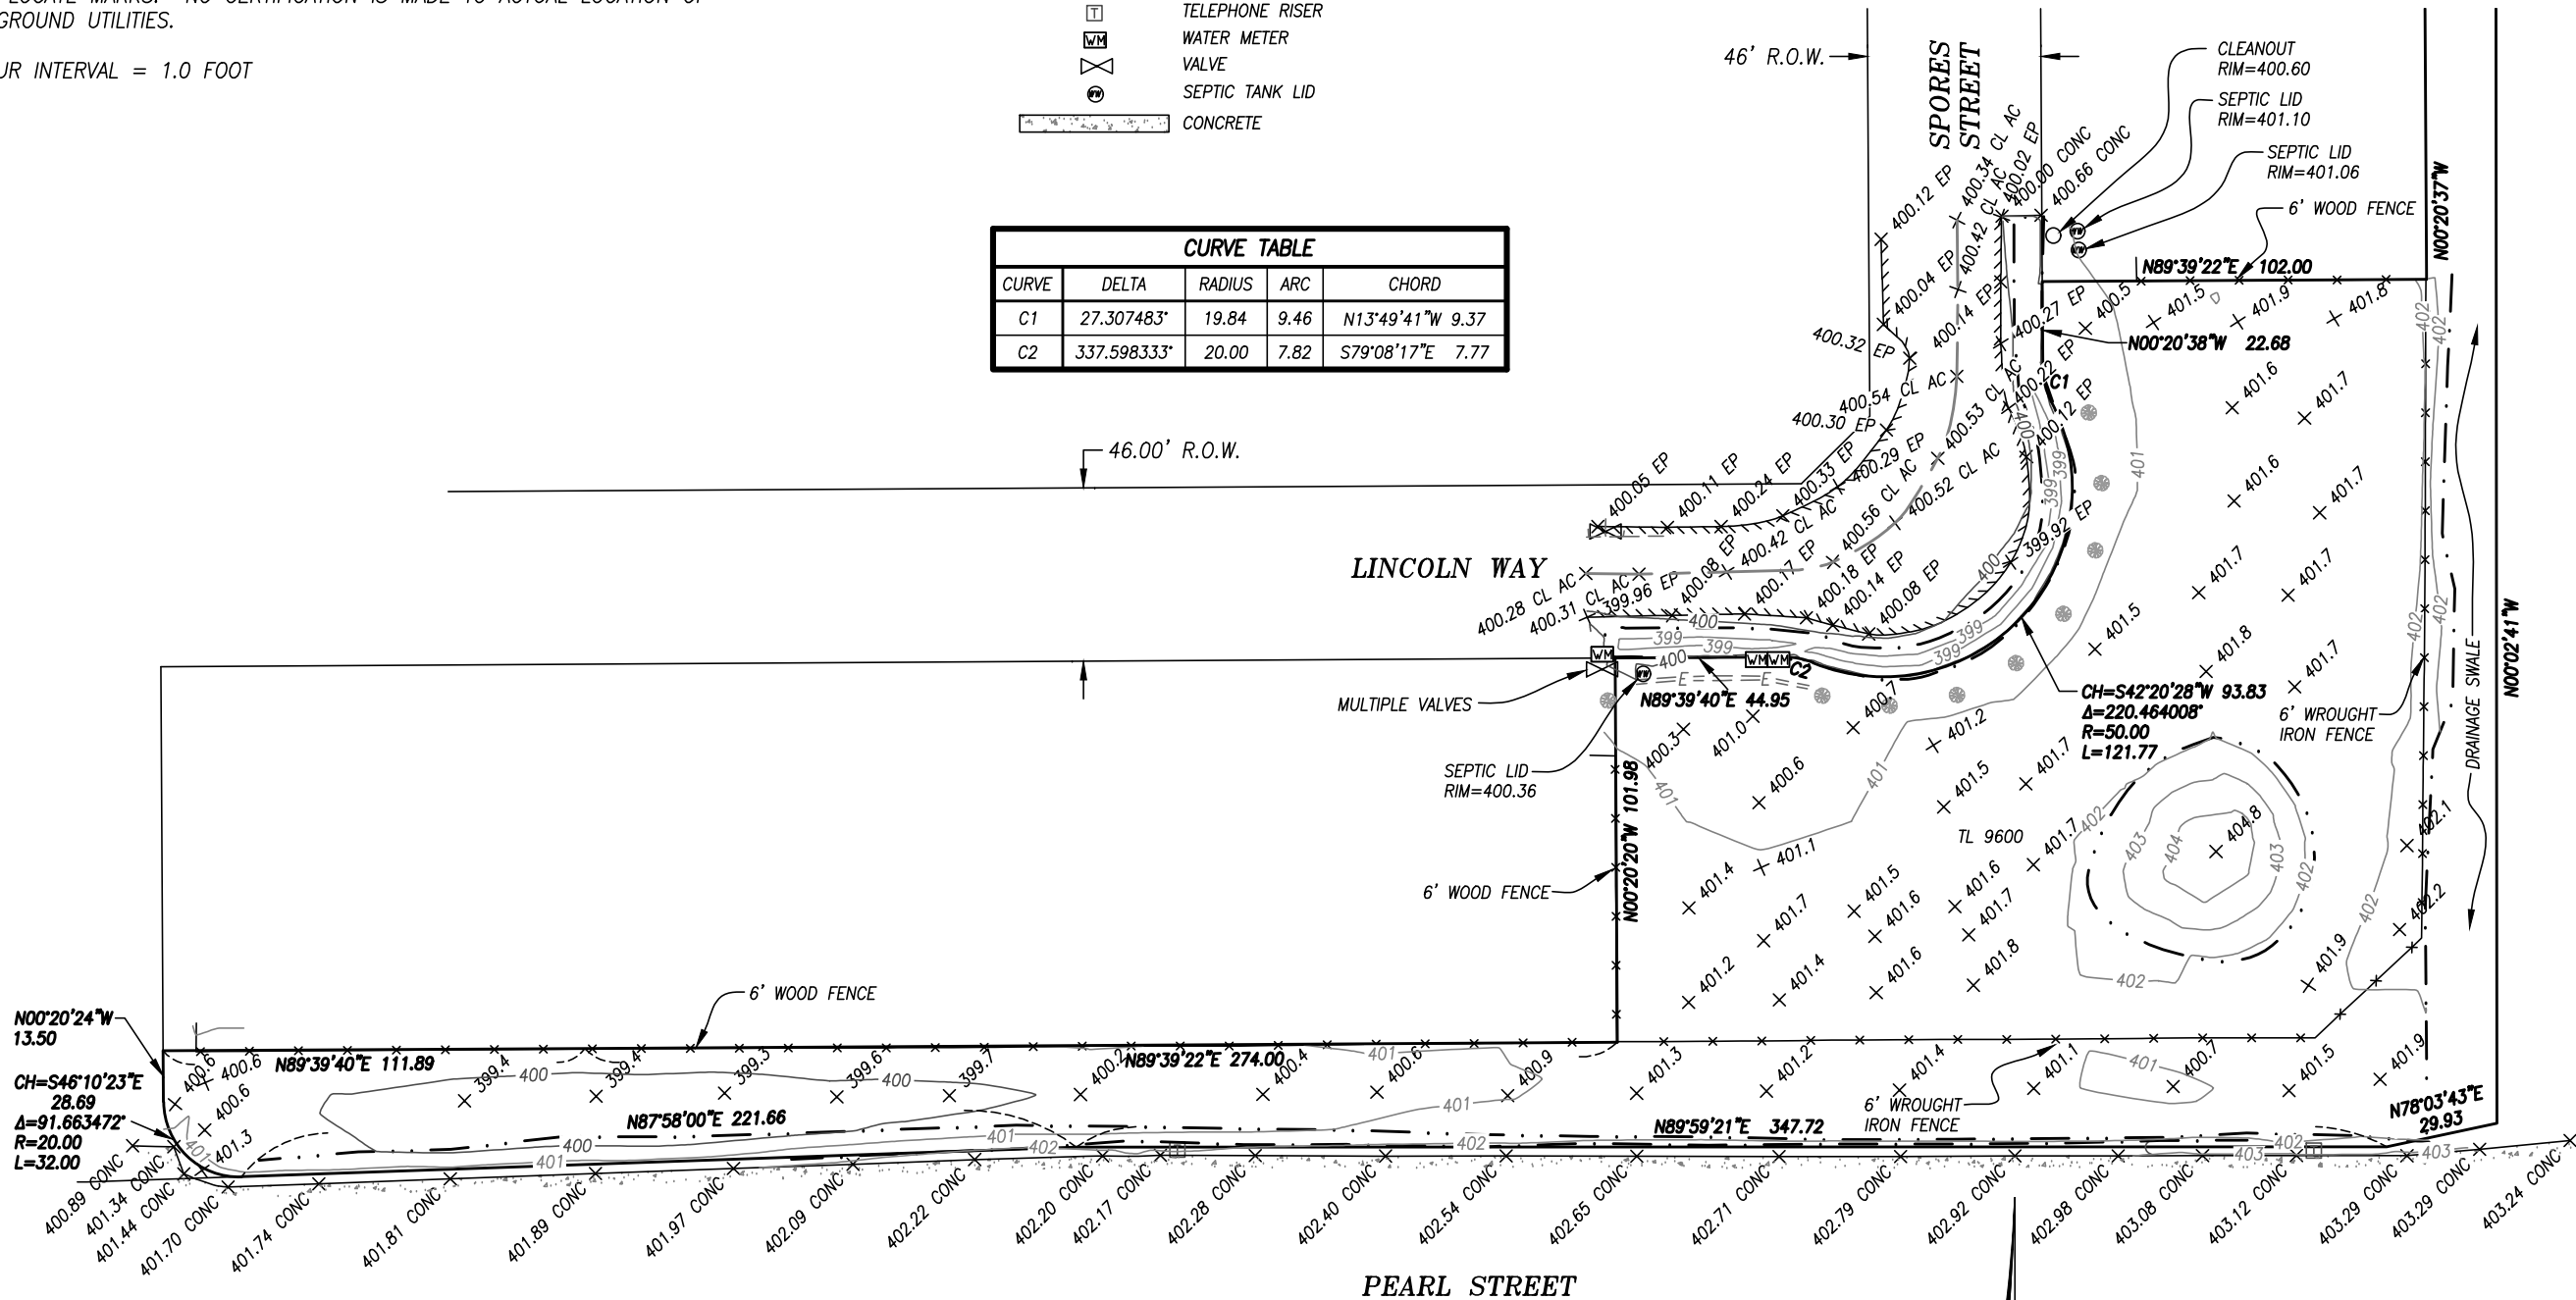

REGISTERED
PROFESSIONAL
LAND SURVEYOR

OREGON
MAY 12, 2011
DANIEL ADAM NELSON
84832PLS

EXPIRES: December 31, 2020

Z:\2019\19-004F - Coburg Johnny Diamond Park RFP\Drawings\19-004F EXIST COND.dwg 5/9/2019 1:49 PM JEFFB
copyright © 2019 Branch Engineering, Inc.